


LOCUS PLAN

ZONING: RESIDENCE A

	REQUIRED	PROPOSED
FRONT SETBACK:	25'	27.6'
SIDE SETBACK:	15'	15.4'
REAR SETBACK:	15'	27.4'
BUILDING COVERAGE:	40%	23%

LEGEND	
ERA	EXISTING RECHARGE AREA
○ EMH	EXISTING MANHOLE
— G —	EXISTING GAS LINE
— W —	EXISTING WATER LINE
---	EXISTING PROPERTY LINE
- - - 49 - - -	EXISTING CONTOUR
◦ IB	EXISTING IRRIGATION BOX
◦ DS	EXISTING DOWN SPOUT
□ HVAC	EXISTING HEATING AND AIR CONDITION CONDENSER
□ WW	EXISTING WINDOW WELL
◦ OP	EXISTING OBSERVATION PORT
51.5x	EXISTING SPOT GRADE
⊠ GM	EXISTING GAS METER

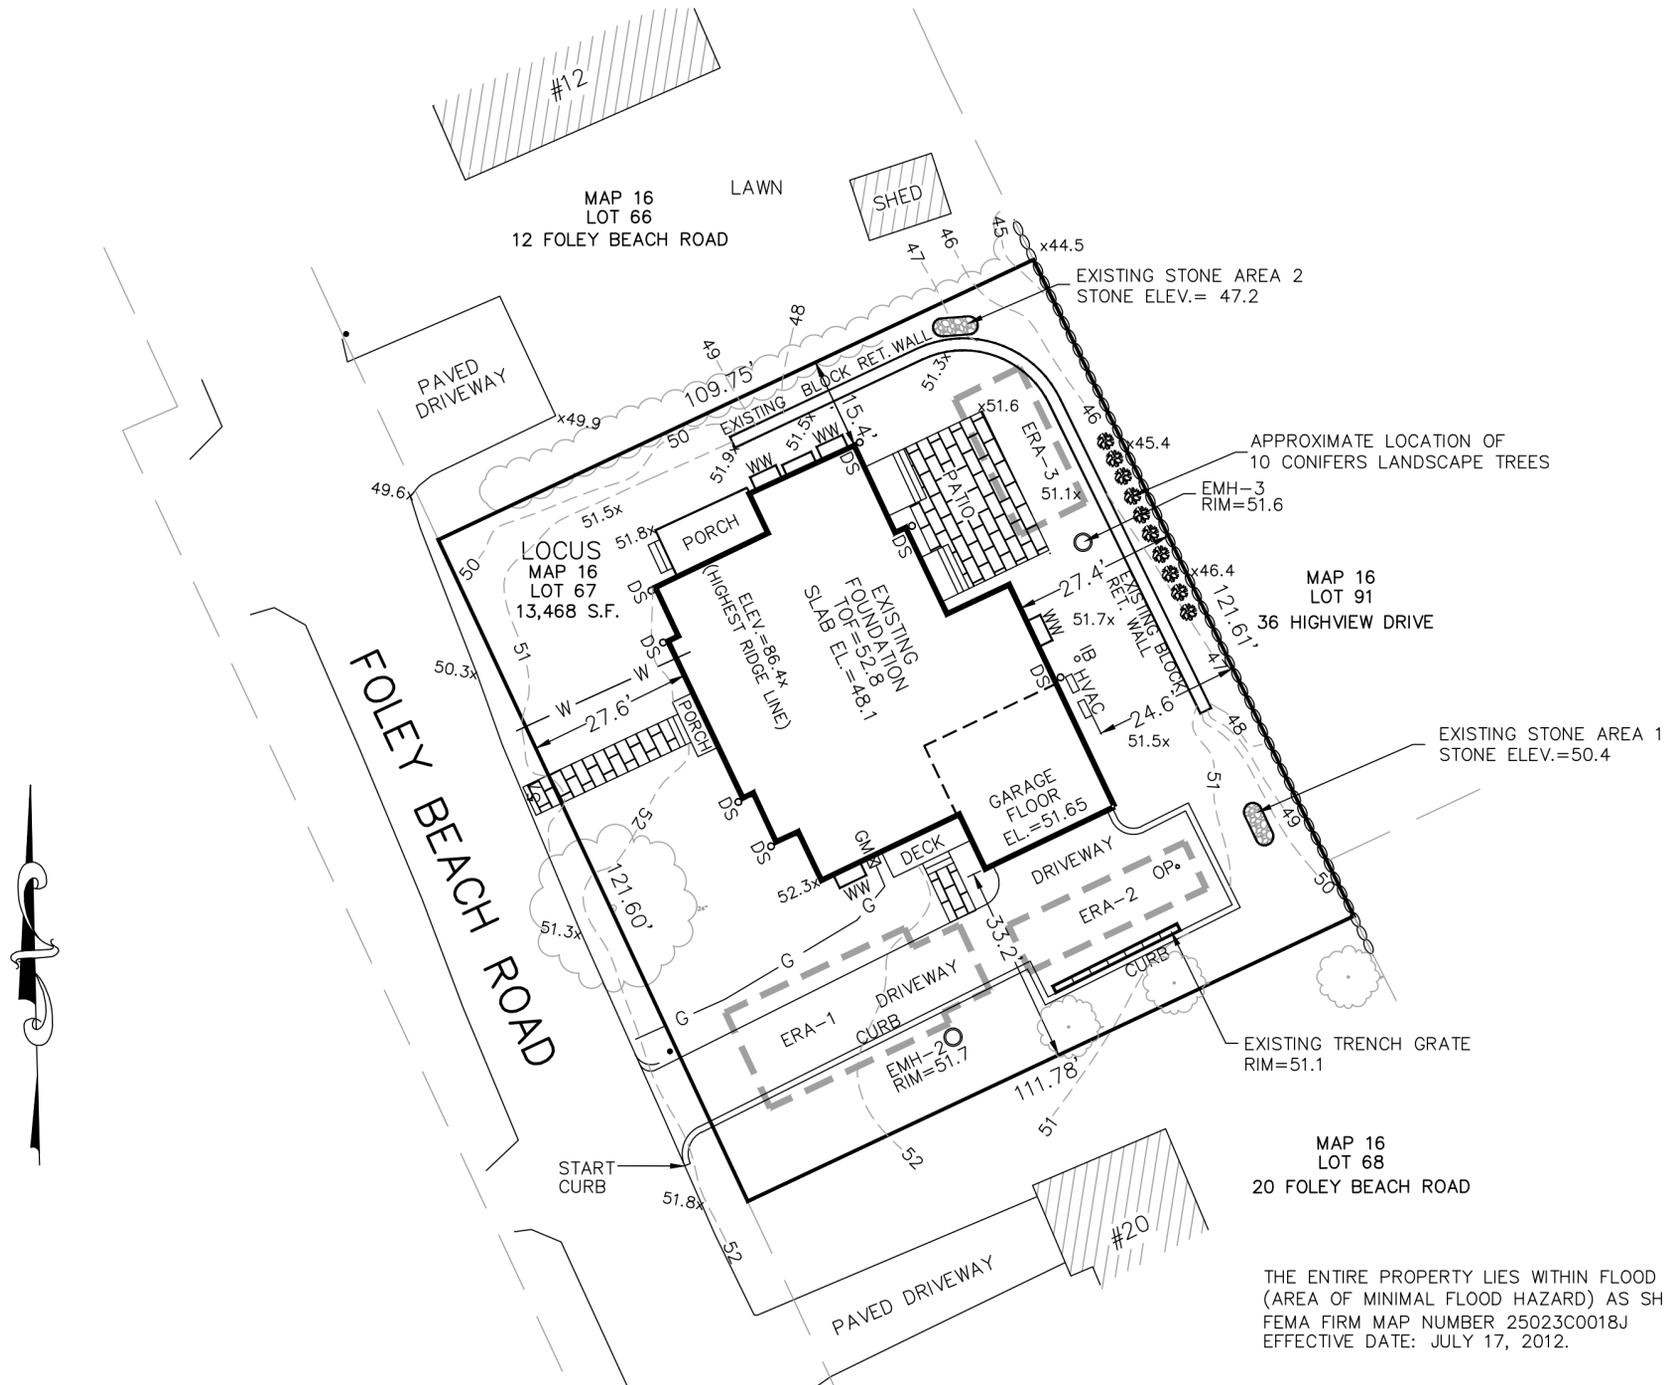

Scale 1" = 20'

THE ENTIRE PROPERTY LIES WITHIN FLOOD ZONE X (AREA OF MINIMAL FLOOD HAZARD) AS SHOWN ON FEMA FIRM MAP NUMBER 25023C0018J EFFECTIVE DATE: JULY 17, 2012.


UNDERGROUND UTILITY NOTE:

ALL EXISTING UNDERGROUND UTILITY LOCATIONS, AS SHOWN ON THIS PLAN, ARE BASED ON CONTRACTOR PROVIDED INFORMATION. UNDERGROUND UTILITY LOCATIONS ARE APPROXIMATE AND MAY NOT REPRESENT ALL UNDERGROUND UTILITIES OR SERVICE LINES. CONTRACTOR IS RESPONSIBLE FOR VERIFYING EXACT LOCATIONS, DEPTH, SIZE AND TYPE OF UTILITIES OR SERVICE LINES PRIOR TO ANY FUTURE CONSTRUCTION. CONTRACTOR SHALL NOTIFY THE TOWN OF ANY DISCREPANCIES.

REFERENCES

PLYMOUTH COUNTY REGISTRY OF DEEDS
 LAND COURT CERTIFICATE NO. 135903
 LAND COURT PLAN NO. 25745-A
 PLAN NO. 344 OF 1964
 HINGHAM ASSESSOR'S MAP 16, LOT 67

1	1-27-2026	EXISTING TREES SHOWN / TOWN COMMENTS	DJK	GRC
1	1-6-2026	STONE PIT 2 AND LANDSCAPE TREES	DJK	GRC
REV.	DATE	DESCRIPTION	BY	APP.
DRAWING TITLE		SITE AS-BUILT		
PROJECT		16 FOLEY BEACH ROAD HINGHAM, MA		
CLIENT		HILLTOP PROPERTY GROUP, LLC 47 G STREET, BOSTON, MA 02127		
SCALE:		AS SHOWN		
DATE:		11-6-25		
DRAWN BY:		DJK		
DESIGNED BY:		DJK		
CHECKED BY:		GRC		
APPROVED BY:		GRC		
DRAWING NO.		23-192-2916		
PROJECT NO.		23-192-2916		

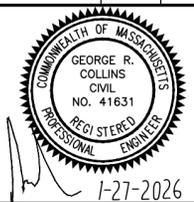

COLLINS CIVIL ENGINEERING GROUP, INC.
 BRAintree - FALMOUTH - WEST BRIDGEWATER
 CIVIL ENGINEERING - LAND SURVEY - L.S.P. SERVICES
 225 SOUTH MAIN STREET, WEST BRIDGEWATER, MA 02379
 TEL:508-580-2332 MOBILE: 617-347-1363 E-MAIL:GRCPE@AOL.COM