


SEPTIC SYSTEM AS-BUILT
#359 EAST STREET
HINGHAM, MASSACHUSETTS

ELEVATIONS

	ACTUAL	PROPOSED
TOP OF FOUNDATION	=52.48	=52.48
BLDG OUT	=46.10	BELOW SLAB
SINGLAIR TANK IN	=45.52	=43.00
SINGLAIR TANK OUT	=45.30	=42.75
PUMP CHAMBER IN(4")	=45.11	=42.65
PUMP CHAMBER OUT(2")	=45.34	=42.4±
LATERALS(1.5")	=44.58	=44.51

INSTALLER:
C.J. ROBINSON
P.O. BOX 387
NO. SCITUATE, MA 02060

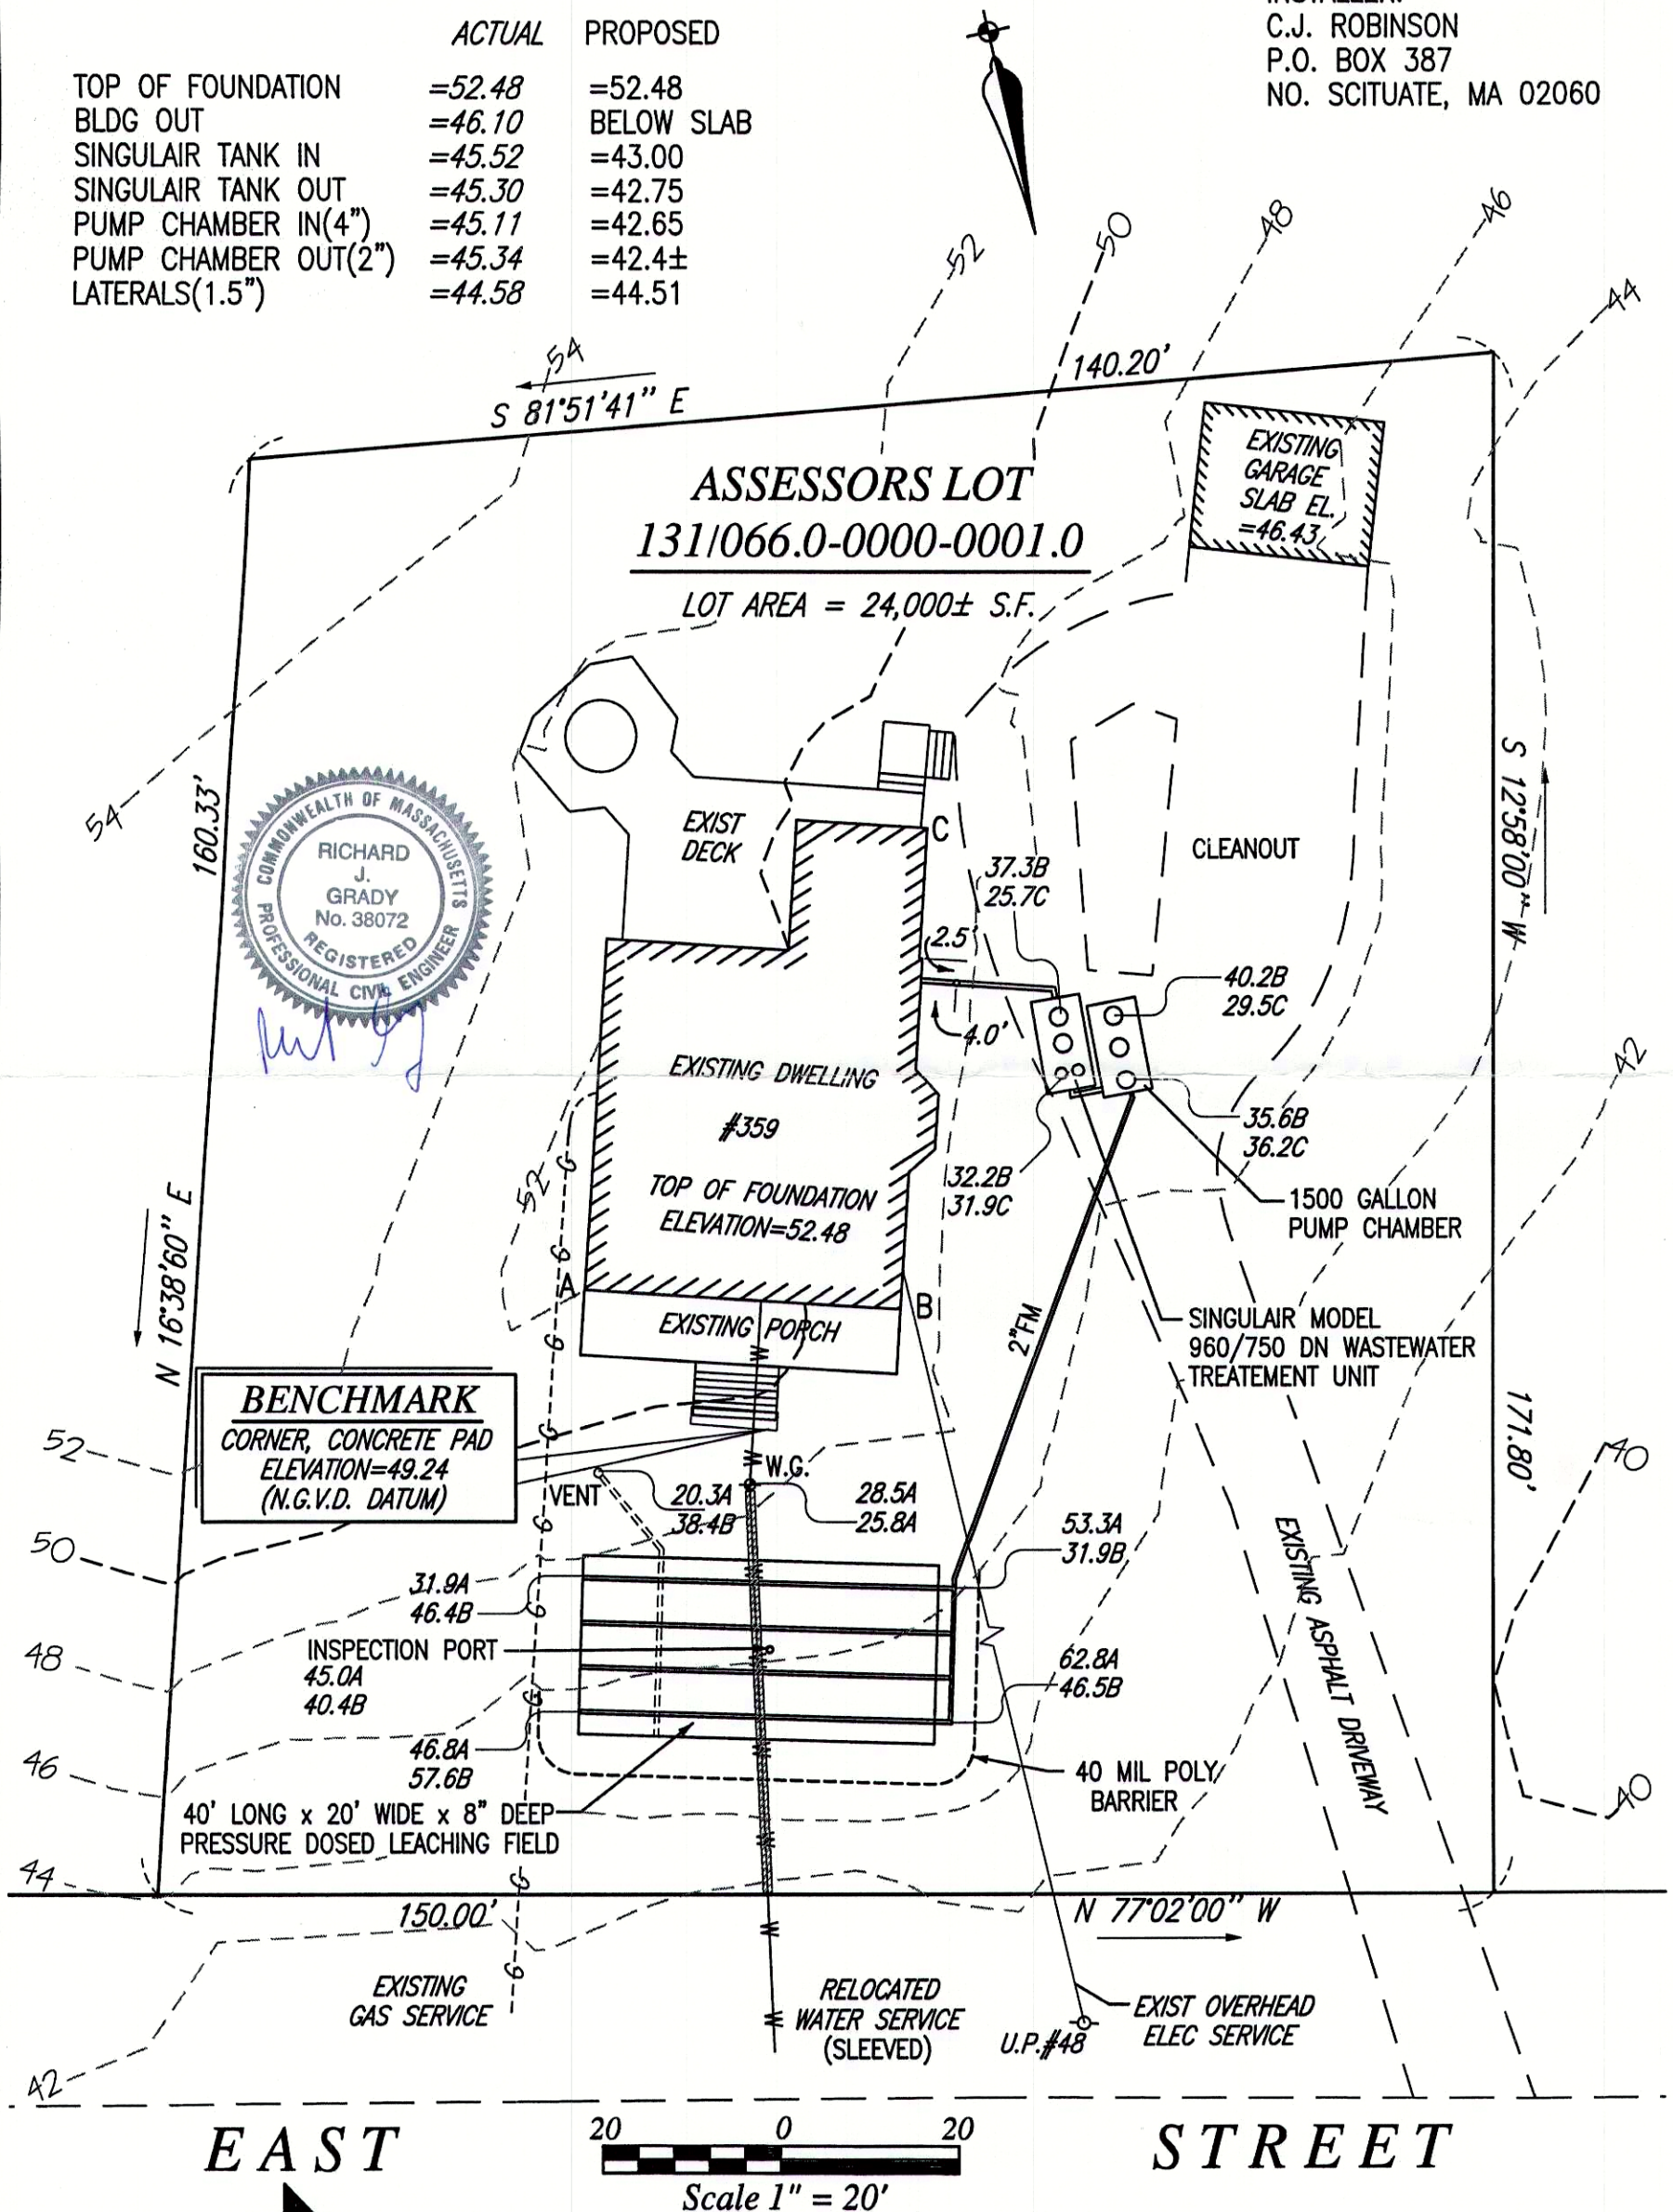

EAST

STREET



GRADY CONSULTING, L.L.C.

Registered Professional Civil Engineers

Applicant/Owner
LAURA SAUTER
359 EAST STREET
HINGHAM, MA 02043

6 GRAYS BEACH ROAD
KINGSTON, MA. 02364
Tel. (781) 585-2300
Fax. (781) 585-2378

JULY 14, 2006
SCALE: 1" = 20'
JOB NO. 06-040