
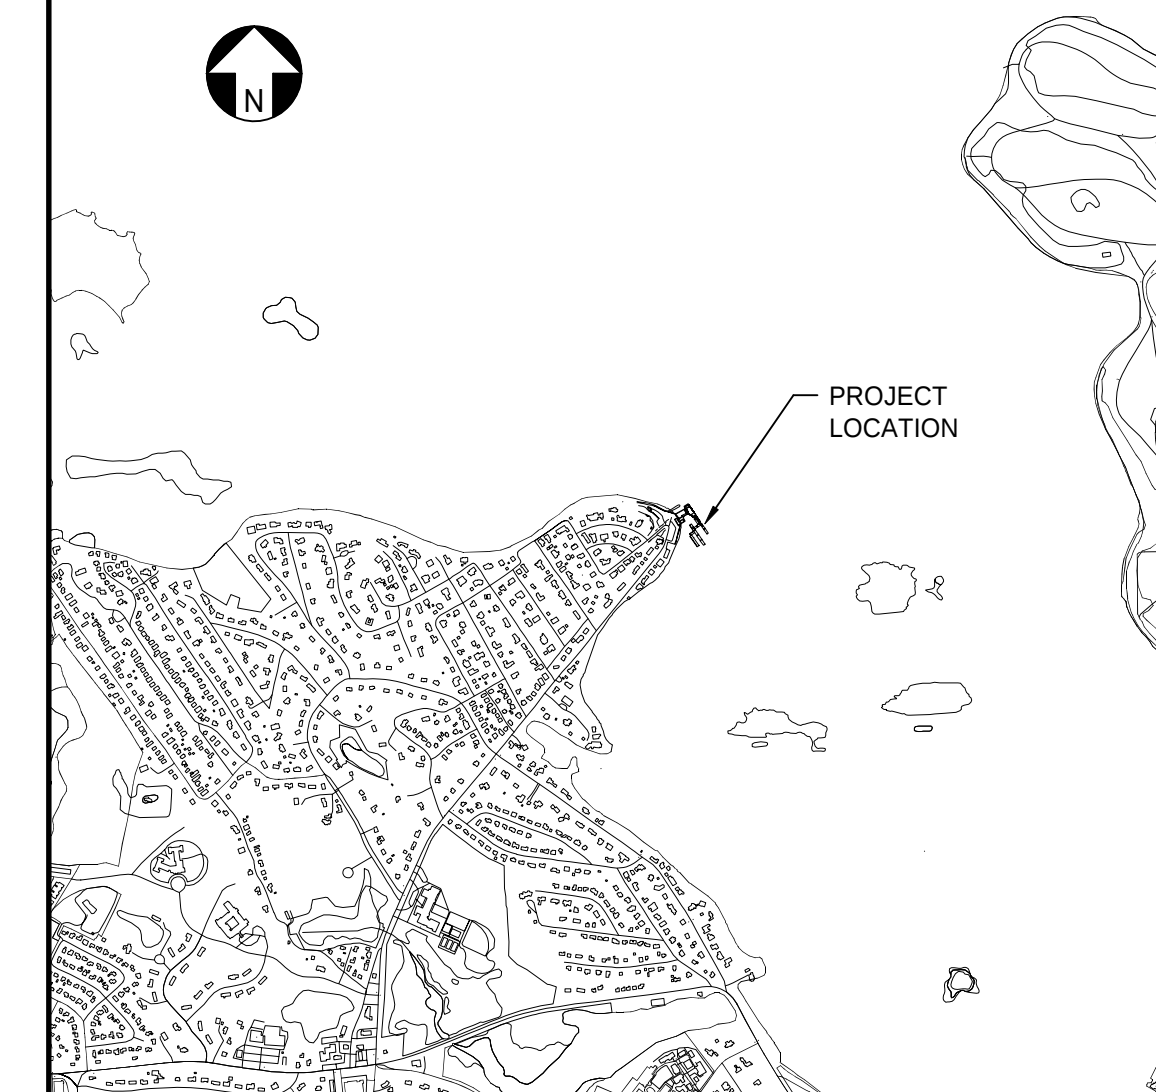


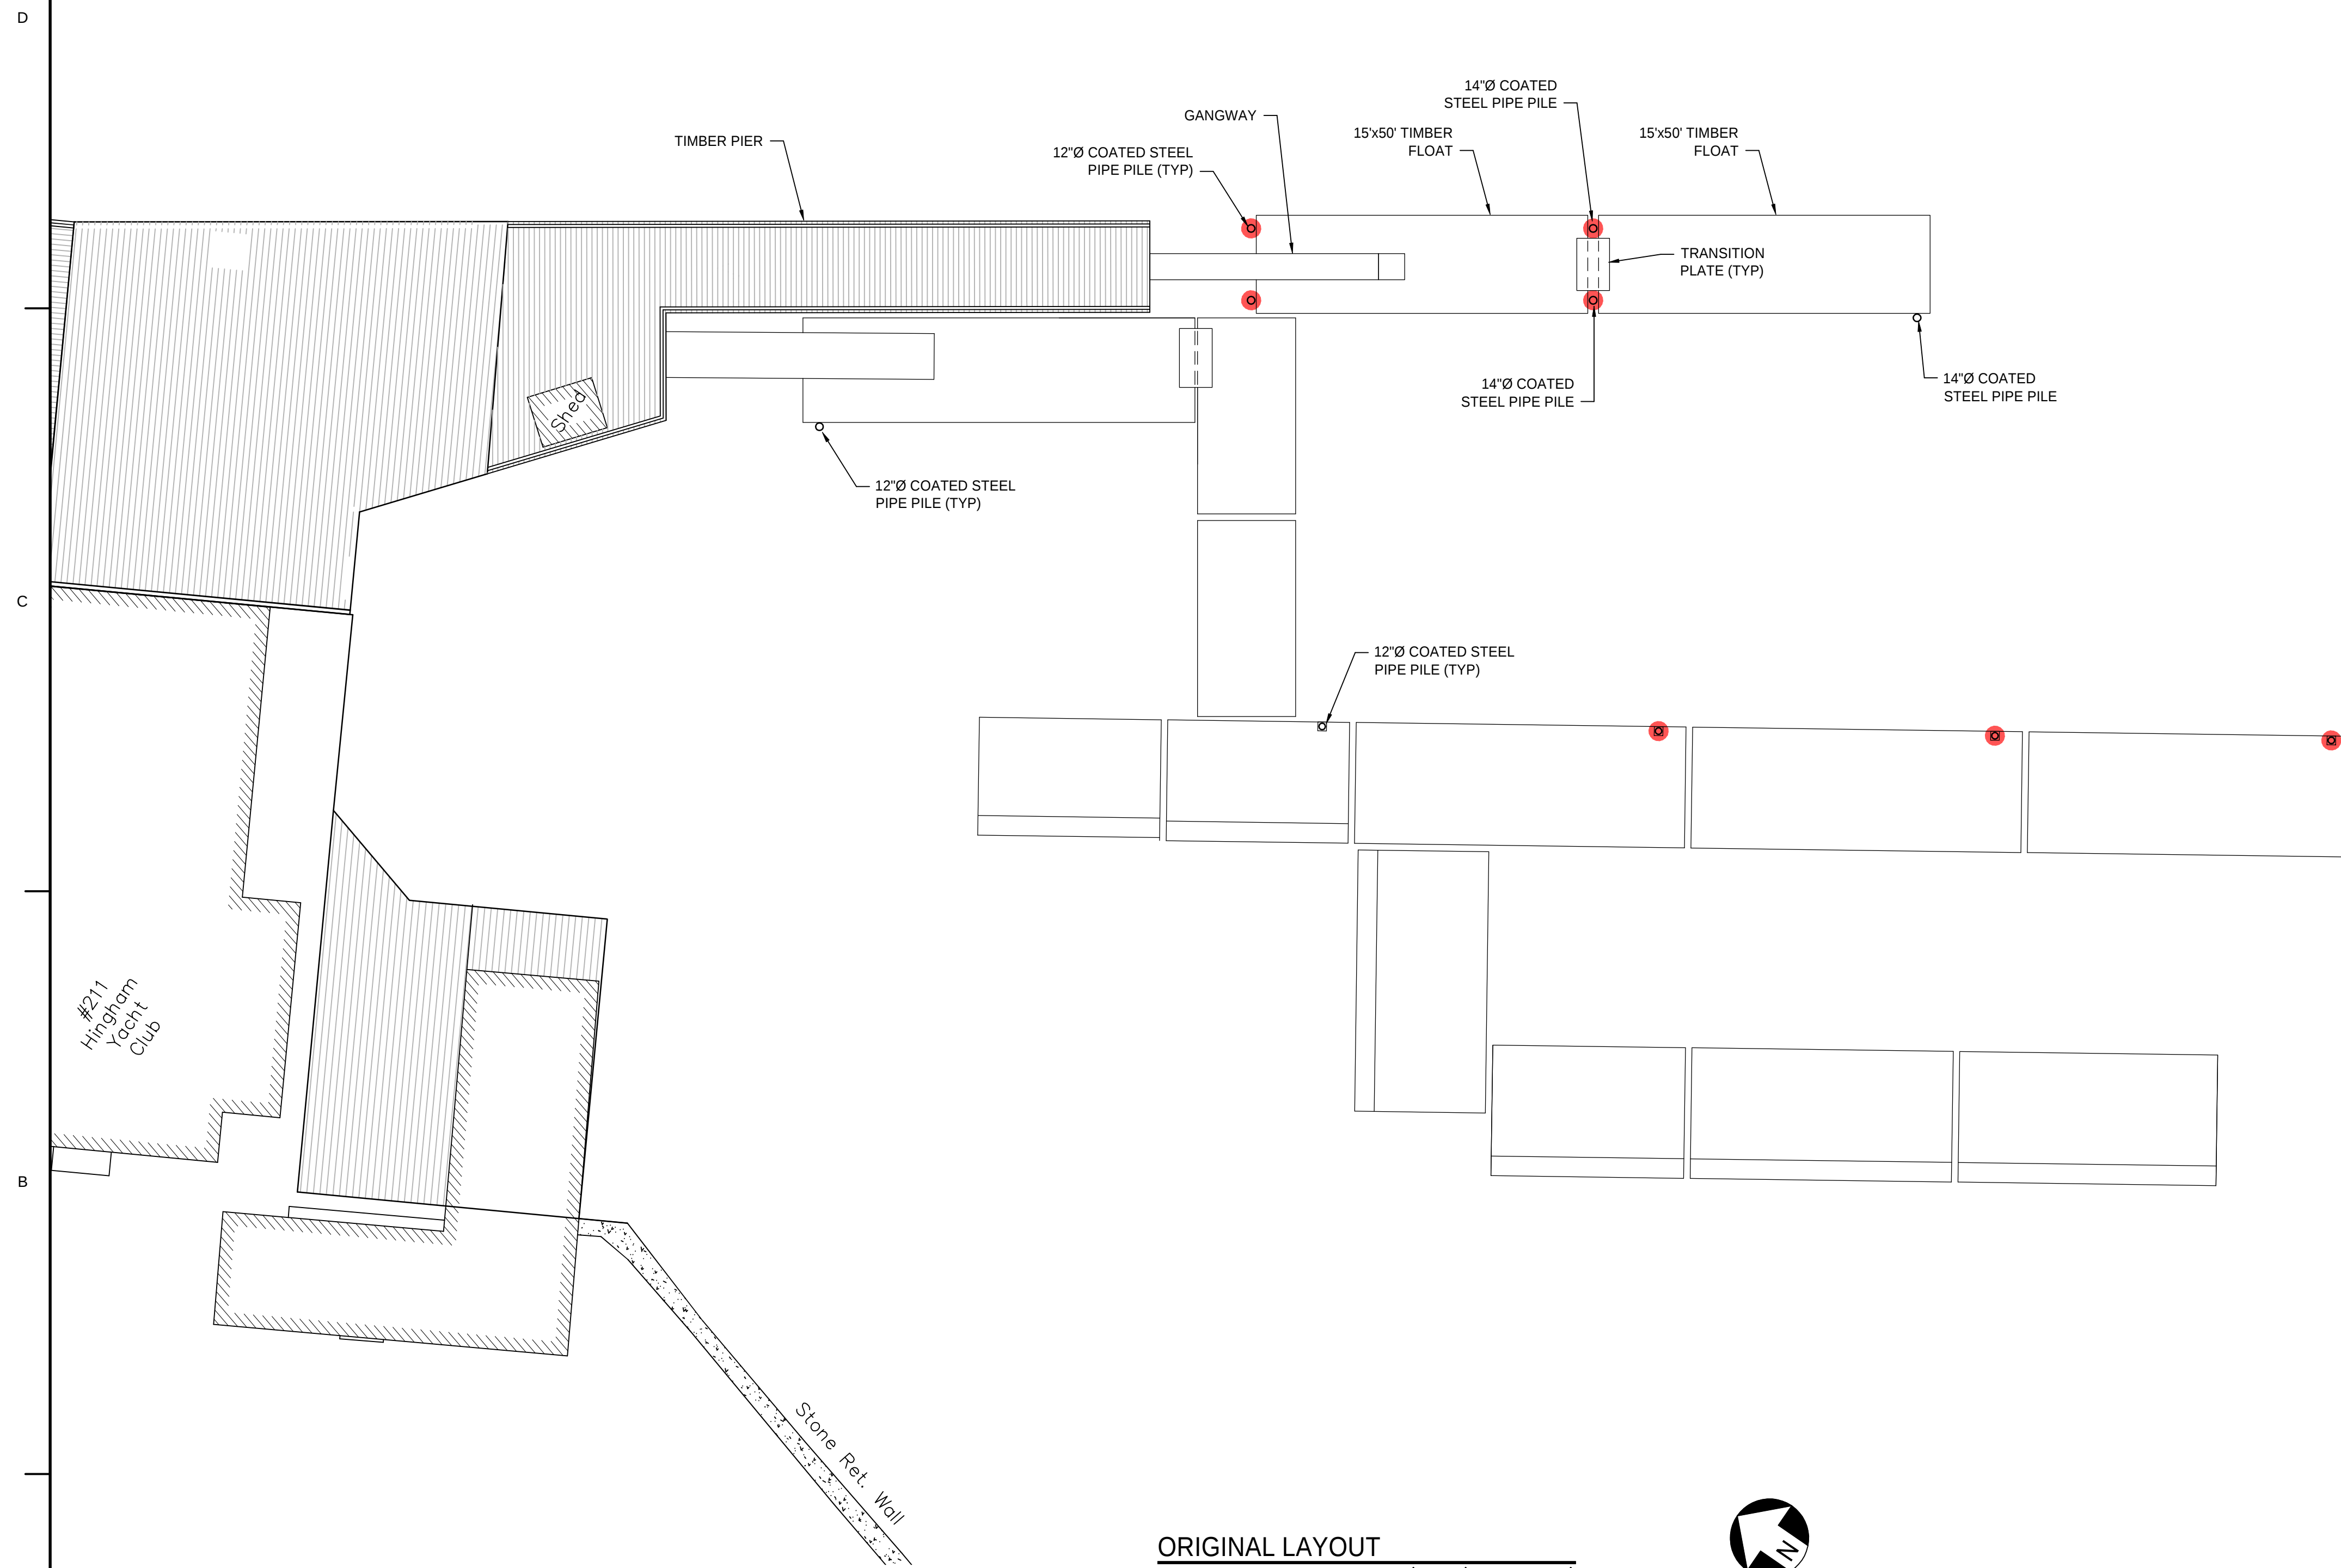

LOCUS PLAN

LEGEND


- ☐ EXISTING PILE TO REMAIN
- ☒ EXISTING PILE TO BE REMOVED

NOTE:

PILES ARE 12" IN DIAMETER UNLESS NOTED OTHERWISE.

ORIGINAL LAYOUT

SCALE: $\frac{1}{8}"=1'-0"$

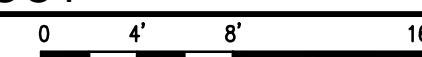

AS-BUILT SET



HINGHAM YACHT CLUB
PIER EXPANSION AND DOCK MODIFICATIONS
HINGHAM, MA
ORIGINAL
FLOAT PILE PLAN

Sheet
reference
number:
SK-01
Sheet 1 of

Designed by:	BJP		Date:	08/18/26
Drawn by:	TEQ	Clad by:	BJP	
			Design file no.	309724 SK-01
Reviewed by:	CMR		Scale:	AS NOTED

[illegible]

CHILDS
ENGINEERING
WAY, BELLINGHAM, MA 02019 U.S.A.

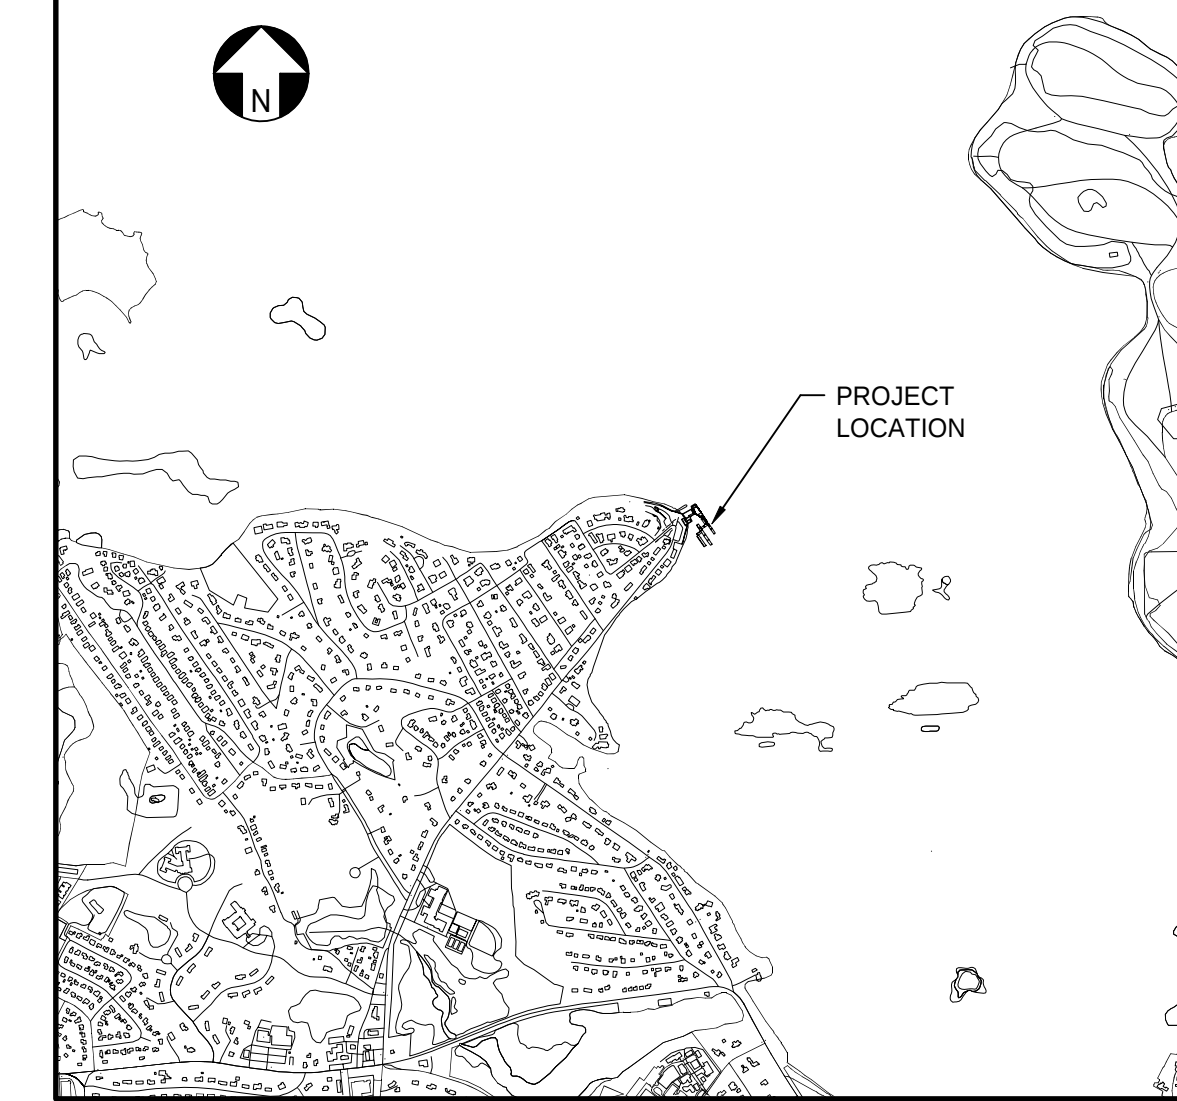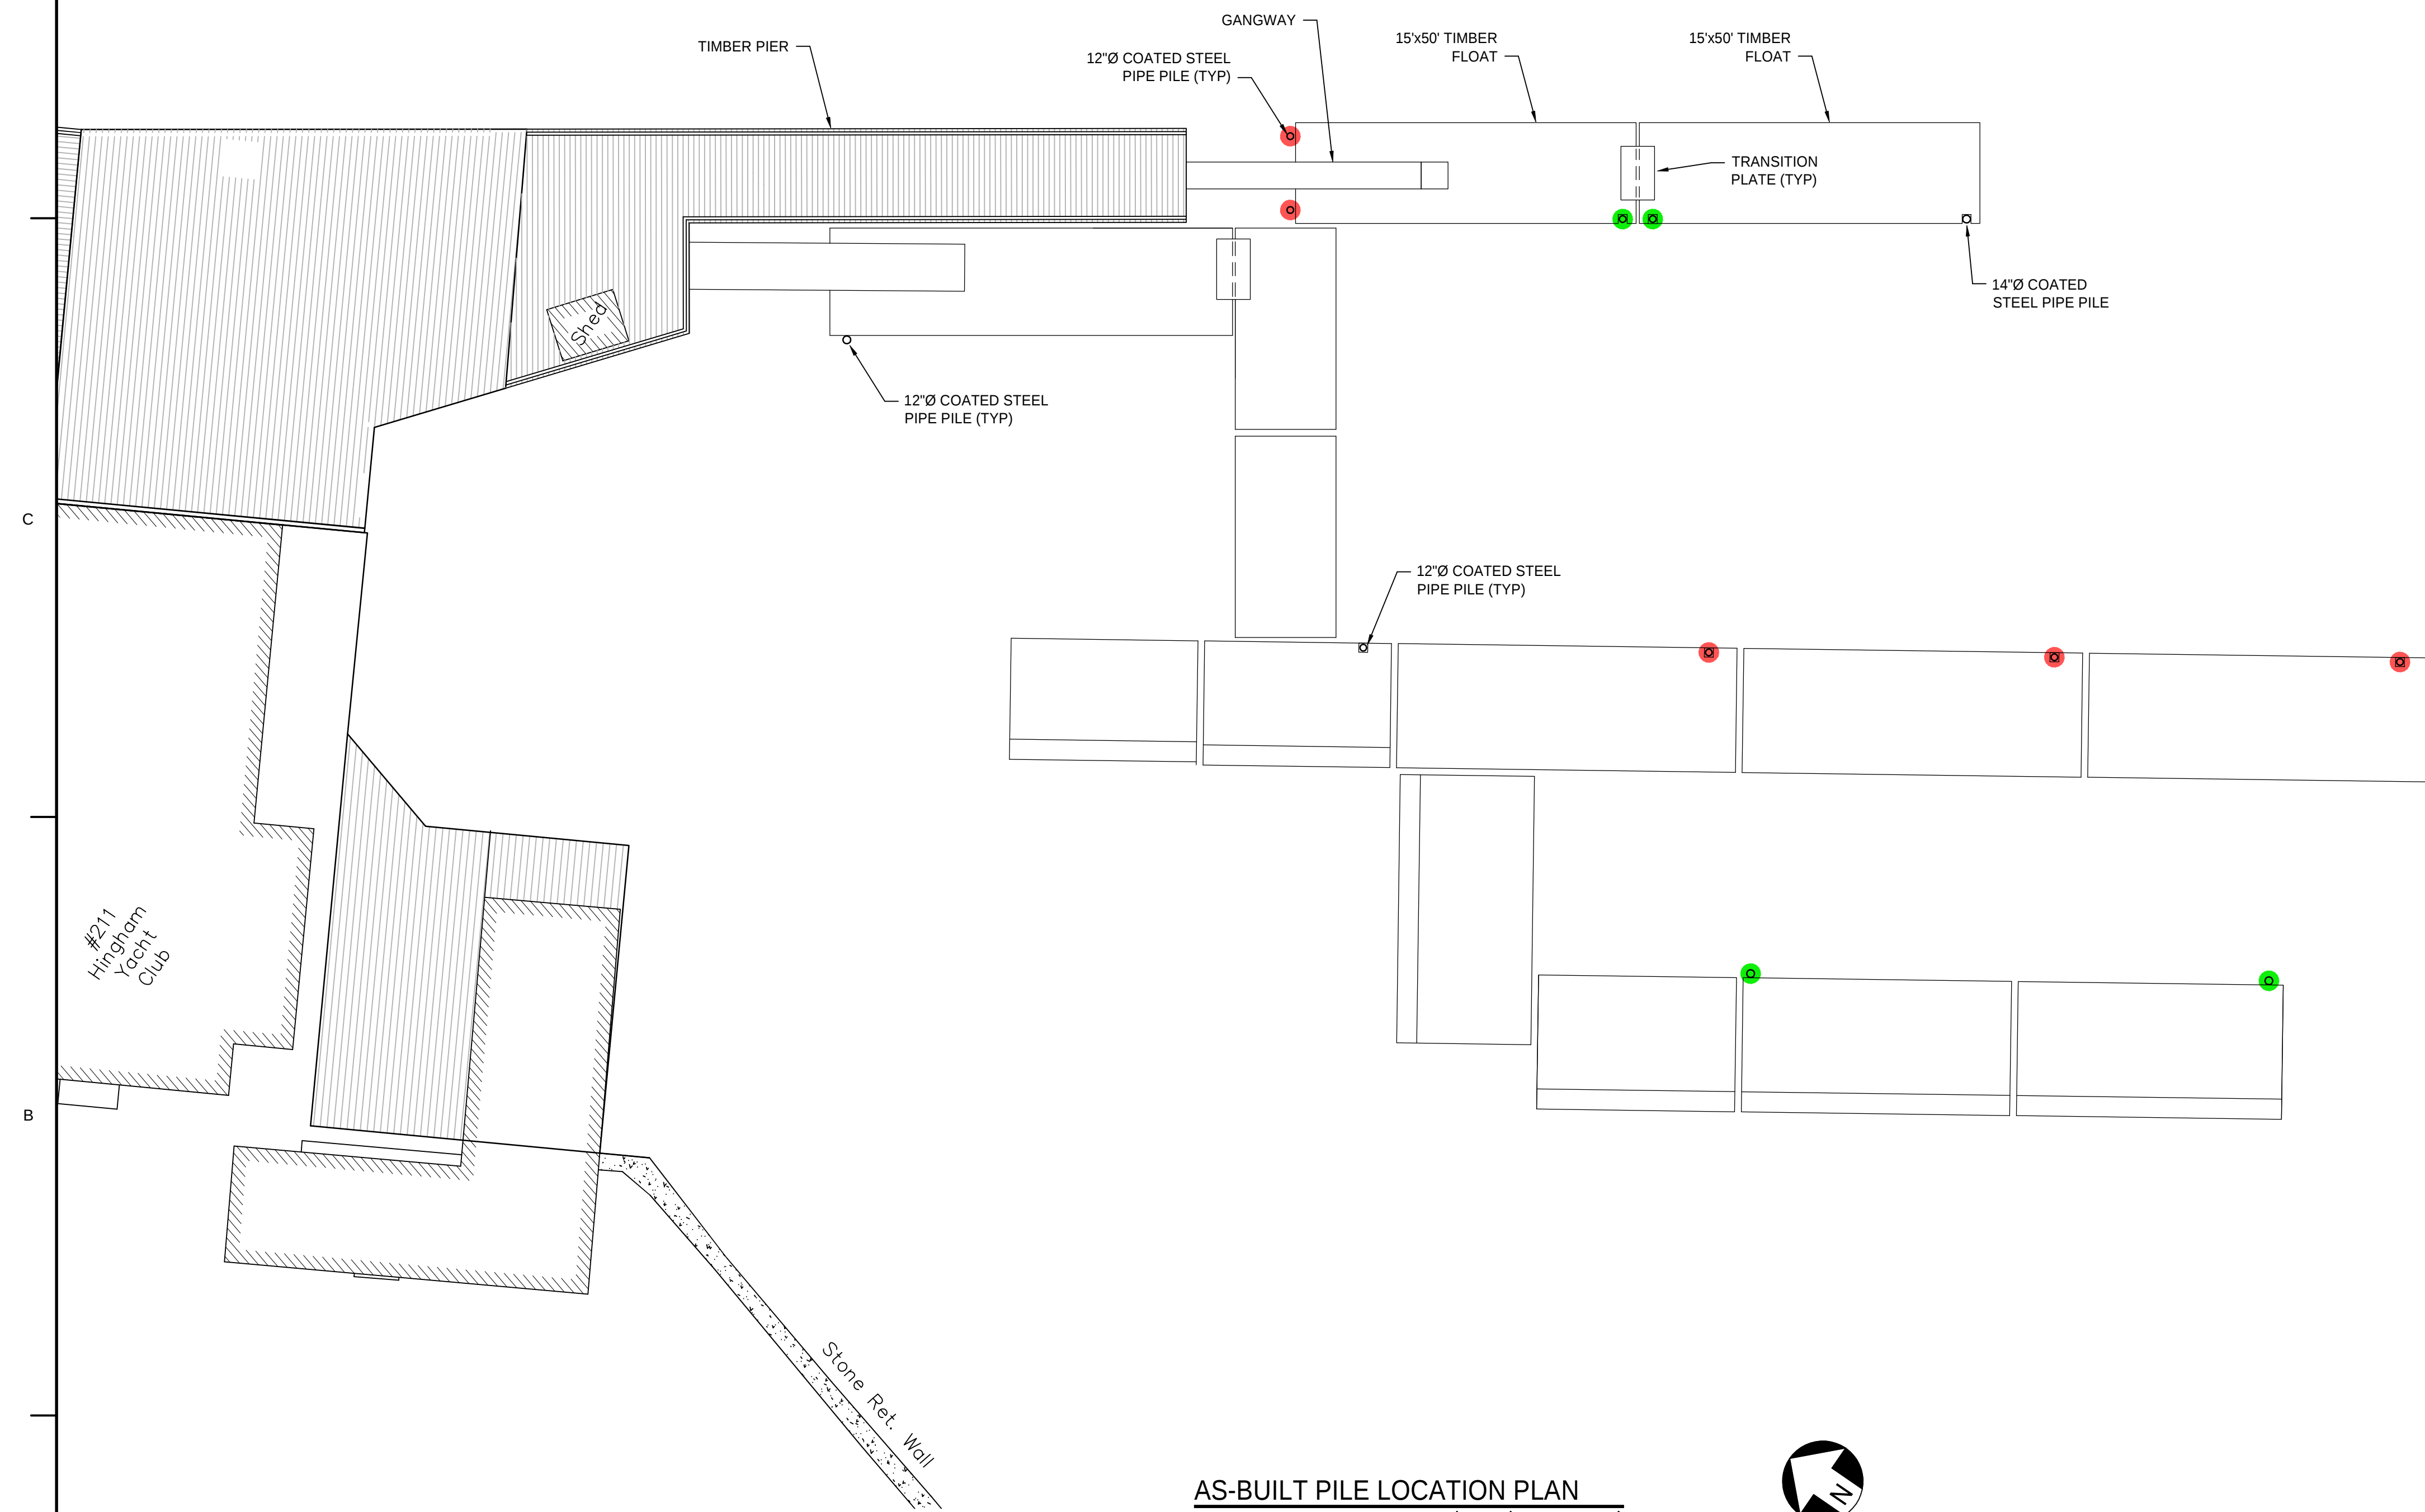

LOCUS PLAN

LEGEND


- EXISTING PILE TO REMAIN
- NEW 12"Ø PILE INSTALLED IN ORIGINAL LOCATION
- NEW 12"Ø PILE INSTALLED IN NEW LOCATION

NOTE:

PILES ARE 12" IN DIAMETER UNLESS NOTED OTHERWISE.

CHILDS
ENGINEERING

34 WILLIAM WAY, BELLINGHAM, MA 02019 U.S.A.
Phone: (509) 866-9092
E-mail: mail@childseng.com

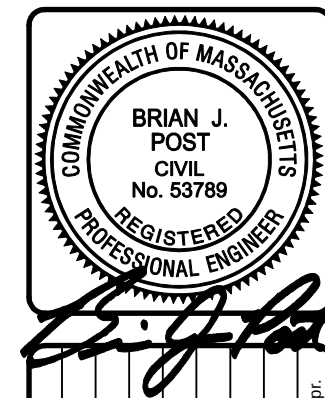[illegible]

Designed by:	BJP	Date:	09/10/26
Drawn by:	TEQ	Design file no:	
		BJP	309724-SK-02
Reviewed by:		Scale:	
		CNR	AS NOTED

HINGHAM YACHT CLUB
PIER EXPANSION AND DOCK MODIFICATIONS
HINGHAM, MA
AS-BUILT
FLOAT PILE PLAN

Sheet
reference
number:
SK-02
Sheet 2 of 2

AS-BUILT SET